

Project Name: Nightcrawler Datacenter NLH

Project No: 29925.n.001

Submission No: 949

Description: NLH6 Replacement Panel Submittal

Manufacturer: Source Blue

Submitted by: Turner

JBB

☐

**NO EXCEPTIONS
TAKEN**

☒

**MAKE CORRECTIONS
NOTED**

☒

**REVISE AND
RESUBMIT**

☐

REJECTED

Review is for general conformance with the design concept and Contract Documents. Markings or comments or the lack thereof, shall not be construed as relieving the Contractor of its responsibility for compliance with all of the requirements of the Contract Documents. The Contractor remains responsible for details and accuracy, for confirming and correlating all quantities and dimensions, for selecting fabrication processes, for the means, methods, and techniques of construction, for performing their work in a safe manner, and for coordinating their work with that of other trades.

☐

**REVIEWED
FOR SPECIFIC ITEMS
ONLY**

This submittal is comprised of data for a product/system for which we are NOT the Engineer of Record and has been reviewed only for the specific items noted.

☐

REVIEWED (AS-BUILT)

This submittal is reviewed for general conformance with as-built conditions.

☐

**RECEIVED FOR
RECORD
NOT REVIEWED**

This submittal is required to be submitted by contract. Receipt is confirmed for record purposes only. This submittal has NOT been reviewed.

☐

NOT REVIEWED

This submittal is comprised of data for a product/system for which we are NOT the Engineer of Record and has NOT been reviewed.

Reviewed by: Alexander Lindner

Date: 7/23/2026

JB&B Comments:***Panel Schedules:***

- *Panel HDP.H02.2 must be equipped with electronic trip breakers for main and all branch breakers. ETU 550 or 560 preferred*
- *Panel DP.H01-2 must be equipped with electronic trip main breaker. ETU 550 or 560 preferred. 100A branch breakers are preferred as electronic trip, ETU 350 or better, but is not required.*

General Comments:

1. *Coordinate work with all trades prior to installation.*
2. *Location of all equipment/products shall comply with all the requirements of the Authorities Having Jurisdiction and all applicable codes.*
3. *All equipment/products shall be installed per manufacturer's requirements and recommendations while maintaining proper clearances.*
4. *All materials shall be listed and installed per their Nationally Recognized Testing Laboratories (NRTL) listing.*
5. *Submit shop drawings to indicate exact locations/application where each piece of equipment/product is being utilized on this project.*

Electrical Comments:

1. JB&B recommended replacements for breakers included in response and marked up on submittal.
2. Panel submittal can be approved as noted with changes indicated in submittal.

Project NLH

Submittal Stamp Page Sheet

Turner Construction

TURNER CONSTRUCTION COMPANY

Reviewed for General Acceptance only. This review does not relieve the Subcontractor of the responsibility for making the work conform to the requirements of the contract. The Subcontractor is responsible for all dimensions, correct fabrication and accurate fit with the work of other trades.

SUBJECT TO ARCHITECTS APPROVAL

Signed: Amanda Rupp Date: 7/23/26

Submittal No: NLH6_230000_Panel Replacement

Turner Construction Submittal Comments


Design Team

PANELBOARD NOTES

SECTION :1 OF 1
PANEL TYPE :P5
CATALOG NUMBER :P5E75ML800HTS
ENCLOSURE :1 Indoor
SYSTEM VOLTAGE :480Y/277 3Ø 4W Wye AC
IR RATING :42 K AIC
MAIN BUS :800 A
BUS MATERIAL :Silver Plated 1000A/Sq in Copper
FEED :Top
MOUNTING :Surface
SE LABEL :No
SERIES RATED :No
CONDUIT AREA :30.000 x 10.75
*INDICATES POSITIONING NUMBERS TO HELP WITH THE
MANUAL PLACEMENT OF BREAKERS ON THE MECHANICAL VIEW
NOTE:THE DIMENSIONS ON THE LEFT ARE FOR THE MINIMUM
SIZE UL LISTED ENCLOSURE REQUIRED FOR THIS
INTERIOR. REFER TO SPEEDFAX FOR ACTUAL ENCLOSURE
DIMENSIONS

PANELBOARD COMPONENTS

Main :
1 - 800A MAIN LUG
1-(3)3/0-500KCMIL
Branches :
2 - 400A /3P-3VA53-HJAS-3P-3VA63 ETU550 LSI 65 KAIC
1-3VA Mechanical (2)2/0-250Kcmil Cu/Al Lug
1-Lug Catalog #: 3VA94730JJ23
2 - 250A /3P-3VA52-HFAS-3P-3VA62 ETU550 LSI 65 KAIC
1-Mechanical (1)#6 AWG- 350 KCMIL AL / CU Lug
1-Lug Catalog #: 3VA92330JB12
2 - 3P-3VA41-HEAB - SPACE
Options :
1-Std Std/Al Gnd Connector
1-Card Holder-Std Plastic Sleeve
1-Al/Cu Branch Connector
1-Certification - UL
1-250kA Panelboard TPS4 SPD
1-SPD Surge Counter

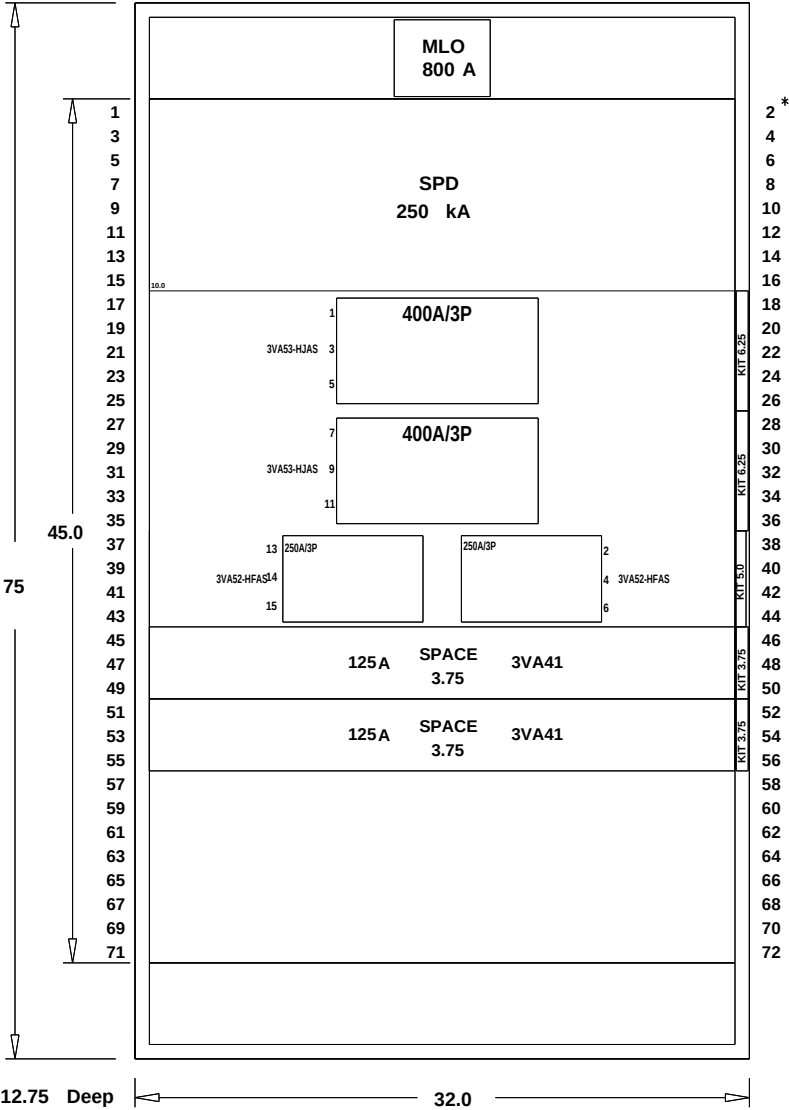


JOB			
JC Bowman Source Blue			
P.O.		CUST.	
CONTR		CRAWFORD ELECTRIC SUPPLYCOMPANY LLC	
TIE		CONSULT	
BY		ENG. LOC.	
DATE		DESIGNATION	
7-22-2026		1DHA.HDP.H02.2	
DWG. NO.			
everhx01c_07222601_00_00_M00-20000-1			
APP.		MFG. LOC.	
APP.		DWG. FILE	
SHEET 1 OF 6		REV.	
1		1	

PANELBOARD NOTES

SECTION :1 OF 1
PANEL TYPE :P5
CATALOG NUMBER :P5E75ML800HTS
ENCLOSURE :1 Indoor
SYSTEM VOLTAGE :480Y/277 3Ø 4W Wye AC
IR RATING :42 K AIC
MAIN BUS :800 A
BUS MATERIAL :Silver Plated 1000A/Sq in Copper
FEED :Top
MOUNTING :Surface
SE LABEL :No
SERIES RATED :No
CONDUIT AREA :30.000 x 10.75
*INDICATES POSITIONING NUMBERS TO HELP WITH THE MANUAL PLACEMENT OF BREAKERS ON THE MECHANICAL VIEW
NOTE:THE DIMENSIONS ON THE LEFT ARE FOR THE MINIMUM SIZE UL LISTED ENCLOSURE REQUIRED FOR THIS INTERIOR. REFER TO SPEEDFAX FOR ACTUAL ENCLOSURE DIMENSIONS

ABBREVIATIONS

'MLO' MAIN LUGS ONLY
'SPD' SURGE PROTECTIVE DEVICE

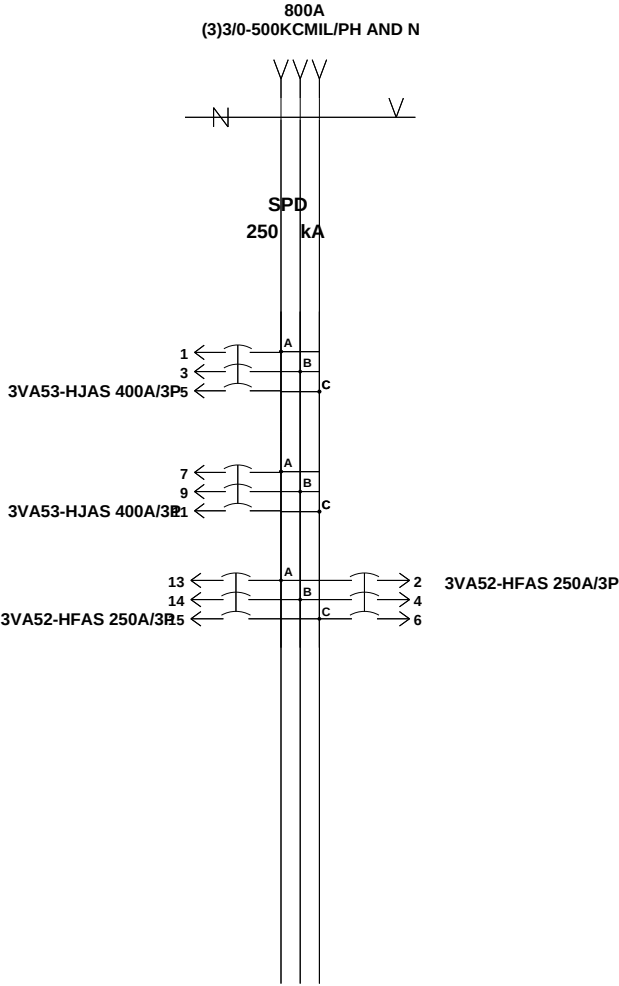

JOB			
JC Bowman Source Blue			
P.O.		CUST.	
-		CRAWFORD ELECTRIC SUPPLYCOMPANY LLC	
CONTR		CONSULT	
-		-	
TIE		BY	ENG. LOC.
-		everhx01c	-
S.O.		DATE	DESIGNATION
-		7-22-2026	1DHA.HDP.H02.2
-		DWG. NO.	
-		everhx01c_07222601_00_00_M00-20000-2	
Siemens Industry, Inc.		APP.	MFG. LOC.
Norcross, Georgia		APP.	DWG. FILE
		SHEET 2	OF 6
		REV.	1

CIRCUIT SCHEDULE

CIRCUIT NUMBER	UNIQUE ID NO.	TRIP AMPS (A)	POLES	DEVICE TYPE	INTERRUPT RATING (AIC)	METER ACC	CT RATING	LOAD LUG SIZE PER PHASE	CIRCUIT IDENTIFICATION
1/3/5	9	400	3	3VA53-HJAS	65,000	N/A	—	(2)2/0-250KCMIL CU/AL	-
7/9/11	11	400	3	3VA53-HJAS	65,000	N/A	—	(2)2/0-250KCMIL CU/AL	-
13/14/15	13	250	3	3VA52-HFAS	65,000	N/A	—	(1)#6 AWG - 350 KCMIL CU/AL	-
16/17/18	18	20	3	SPACE	65,000	N/A	—	(1)#14-#8 CU/AL	-
19/20/21	20	20	3	SPACE	65,000	N/A	—	(1)#14-#8 CU/AL	-
2/4/6	14	250	3	3VA52-HFAS	65,000	N/A	—	(1)#6 AWG - 350 KCMIL CU/AL	-

JOB			
JC Bowman Source Blue			
P.O.		CUST.	
-		CRAWFORD ELECTRIC SUPPLYCOMPANY LLC	
CONTR		CONSULT	
-		-	
TIE		BY	ENG. LOC.
-		everhx01c	-
S.O.		DATE	DESIGNATION
-		7-22-2026	1DHA.HDP.H02.2
DWG. NO.		everhx01c_07222601_00_00_M00-20000-3	
Siemens Industry, Inc.		APP.	MFG. LOC.
Norcross, Georgia		APP.	DWG. FILE
		SHEET 3 OF 6	
		REV. 1	

JOB				
JC Bowman Source Blue				
P.O.		CUST.		
-		CRAWFORD ELECTRIC SUPPLYCOMPANY LLC		
CONTR		CONSULT		
-		-		
TIE		BY	ENG. LOC.	DESIGNATION
-		everhx01c	-	1DHA.HDP.H02.2
S.O.		DATE		
-		7-22-2026		
DWG. NO.		everhx01c_07222601_00_00_M00-20000-4		
Siemens Industry, Inc.		APP.	MFG. LOC.	REV.
Norcross, Georgia		APP.	DWG. FILE	SHEET 4 OF 6
				1

APPLICATION ENGINEERING REPORT

UNIQUE ID NUMBER	DESCRIPTION	APPLICATION DESCRIPTION

JOB			
JC Bowman Source Blue			
P.O.		CUST.	
-		CRAWFORD ELECTRIC SUPPLYCOMPANY LLC	
CONTR		CONSULT	
-		-	
TIE		BY	ENG. LOC.
-		everhx01c	-
S.O.		DATE	DESIGNATION
-		7-22-2026	1DHA.HDP.H02.2
DWG. NO.		everhx01c_07222601_00_00_M00-20000-5	
Siemens Industry, Inc.		APP.	MFG. LOC.
Norcross, Georgia		APP.	DWG. FILE
		SHEET	5 OF 6
		REV.	1

DETAILED CIRCUIT SCHEDULE

Circuit #	Device Type	Device Catalog #	Frame Amp	Trip Amp	Interrupting Class	Trip Unit Type	Load Rating	# Of Poles	Brkr Trip Setting	COMM	DAS/ZSI	Accessories	Load Lug Size Per Phase
1	-	-	-	-	-	-	-	-	-	-	-	-	-
2	-	-	-	-	-	-	-	-	-	-	-	-	(3)3/0-500KCMIL
3	-	-	-	-	-	-	-	-	-	-	-	-	-
4	3VA53-HJAS	3VA53406EC310AA0	400	400	65KAIC	TM	STD	3	-	-	N/N	-	(2)2/0-250KCMIL CU/AL
5	3VA53-HJAS	3VA53406EC310AA0	400	400	65KAIC	TM	STD	3	-	-	N/N	-	(2)2/0-250KCMIL CU/AL
6	3VA52-HFAS	3VA52256EC310AA0	250	250	65KAIC	TM	STD	3	-	-	N/N	-	(1)#6 AWG - 350 KCMIL CU/AL
7	3VA52-HFAS	3VA52256EC310AA0	250	250	65KAIC	TM	STD	3	-	-	N/N	-	(1)#6 AWG - 350 KCMIL CU/AL
8	-	-	-	-	-	-	-	-	-	-	-	-	-
9	-	-	125	20	65KAIC	TM	STD	3	-	-	N/N	-	(1)#14-#8 CU/AL
10	-	-	-	-	-	-	-	-	-	-	-	-	-
11	-	-	125	20	65KAIC	TM	STD	3	-	-	N/N	-	(1)#14-#8 CU/AL

JOB			
JC Bowman Source Blue			
P.O.		CUST.	
-		CRAWFORD ELECTRIC SUPPLYCOMPANY LLC	
CONTR		CONSLT	
-		-	
TIE		BY	ENG. LOC.
-		everhx01c	-
S.O.		DATE	DESIGNATION
-		7-22-2026	1DHA.HDP.H02.2
DWG. NO.		everhx01c_07222601_00_00_M00-20000-6	
Siemens Industry, Inc.		APP.	MFG. LOC.
Norcross, Georgia		APP.	DWG. FILE
		SHEET 6 OF 6	
		REV. 1	

PANELBOARD NOTES


SECTION :1 OF 1
PANEL TYPE :P5
CATALOG NUMBER :P5E75ML600HTS
ENCLOSURE :1 Indoor
SYSTEM VOLTAGE :480Y/277 3Ø 4W Wye AC
IR RATING :42 K AIC
MAIN BUS :600 A
BUS MATERIAL :Silver Plated 1000A/Sq in Copper
FEED :Top
MOUNTING :Surface
SE LABEL :No
SERIES RATED :No
CONDUIT AREA :30.000 x 10.75
*INDICATES POSITIONING NUMBERS TO HELP WITH THE MANUAL PLACEMENT OF BREAKERS ON THE MECHANICAL VIEW
NOTE:THE DIMENSIONS ON THE LEFT ARE FOR THE MINIMUM SIZE UL LISTED ENCLOSURE REQUIRED FOR THIS INTERIOR. REFER TO SPEEDFAX FOR ACTUAL ENCLOSURE DIMENSIONS

PANELBOARD COMPONENTS

Main :
~~1 - 600A MAINBREAKER~~ 3P-3VA64 ETU 550 65 KAIC
1-(2)3/0-500KCMIL

BRANCHES :
12 - 20A /1P-3VA41-HEAB
1-3VA Mechanical (1)#14-#8 AL/Cu Lug
4 - 100A /3P-3VA41-HEAB ← RECOMMEND 3VA61 ETU 350 OR 550, 65 KAIC
1-3VA Mechanical (1)#14-3/0 AL / CU Lug
4 - 3P-3VA41-HEAB - SPACE

Options :
1-Std Stl/Al Gnd Connector
1-Card Holder-Std Plastic Sleeve
1-Al/Cu Branch Connector
1-Certification - UL

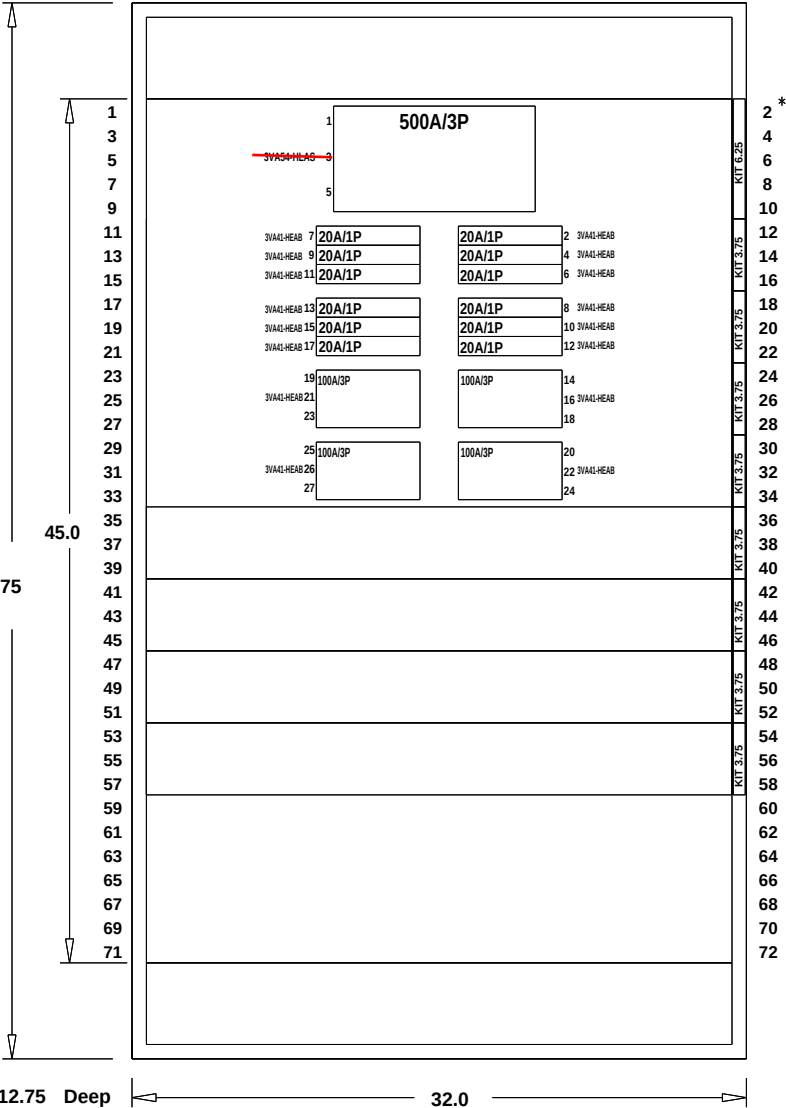

JOB			
JC Bowman Source Blue			
P.O.		CUST.	
=		CRAWFORD ELECTRIC SUPPLYCOMPANY LLC	
CONTR		CONSULT	
=		=	
TIE		BY	
=		everhx01c	
S.O.		DATE	
=		7-22-2026	
=		DESIGNATION	
=		1DHA.DP.H01-2	
DWG. NO.			
everhx01c_07222601_00_00_M00-21000-1			
Siemens Industry, Inc.			
APP.		MFG. LOC.	
APP.		DWG. FILE	
SHEET 1 OF 6		REV. 1	


1	0	everhx01c072226	7-22-2026
NO.	REVISIONS	DRAWN BY	DATE

PANELBOARD NOTES

SECTION :1 OF 1
PANEL TYPE :P5
CATALOG NUMBER :P5E75ML600HTS
ENCLOSURE :1 Indoor
SYSTEM VOLTAGE :480Y/277 3Ø 4W Wye AC
IR RATING :42 K AIC
MAIN BUS :600 A
BUS MATERIAL :Silver Plated 1000A/Sq in Copper
FEED :Top
MOUNTING :Surface
SE LABEL :No
SERIES RATED :No
CONDUIT AREA :30.000 x 10.75
*INDICATES POSITIONING NUMBERS TO HELP WITH THE MANUAL PLACEMENT OF BREAKERS ON THE MECHANICAL VIEW
NOTE:THE DIMENSIONS ON THE LEFT ARE FOR THE MINIMUM SIZE UL LISTED ENCLOSURE REQUIRED FOR THIS INTERIOR. REFER TO SPEEDFAX FOR ACTUAL ENCLOSURE DIMENSIONS

ABBREVIATIONS

'MLO' MAIN LUGS ONLY

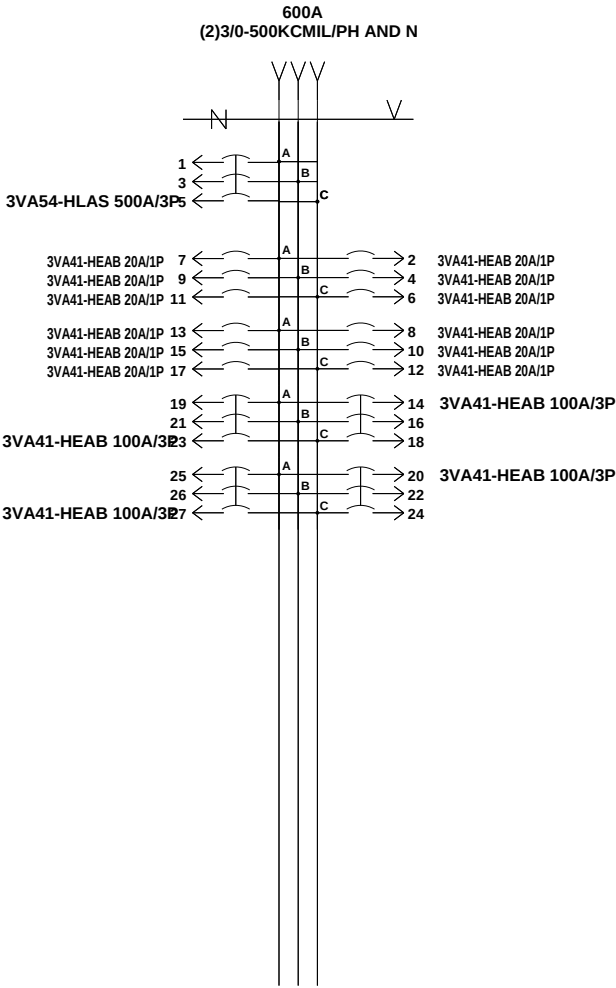

JOB			
JC Bowman Source Blue			
P.O.		CUST.	
-		CRAWFORD ELECTRIC SUPPLYCOMPANY LLC	
CONTR		CONSULT	
-		-	
TIE		BY	ENG. LOC.
-		everhx01c	-
S.O.		DATE	DESIGNATION
-		7-22-2026	1DHA.DP.H01-2
-		DWG. NO.	
-		everhx01c_07222601_00_00_M00-21000-2	
Siemens Industry, Inc.		APP.	MFG. LOC.
Norcross, Georgia		APP.	DWG. FILE
		SHEET	2 OF 6
		REV.	1

CIRCUIT SCHEDULE

CIRCUIT NUMBER	UNIQUE ID NO.	TRIP AMPS (A)	POLES	DEVICE TYPE	INTERRUPT RATING (AIC)	METER ACC	CT RATING	LOAD LUG SIZE PER PHASE	CIRCUIT IDENTIFICATION
1/3/5	127	500	3	3VA54-HLAS	65,000	N/A	—	(2)2/0-500KCMIL CU/AL	-
7	113	20	1	3VA41-HEAB	65,000	N/A	—	(1)#14-#8 CU/AL	-
9	115	20	1	3VA41-HEAB	65,000	N/A	—	(1)#14-#8 CU/AL	-
11	117	20	1	3VA41-HEAB	65,000	N/A	—	(1)#14-#8 CU/AL	-
13	120	20	1	3VA41-HEAB	65,000	N/A	—	(1)#14-#8 CU/AL	-
15	122	20	1	3VA41-HEAB	65,000	N/A	—	(1)#14-#8 CU/AL	-
17	124	20	1	3VA41-HEAB	65,000	N/A	—	(1)#14-#8 CU/AL	-
19/21/23	107	100	3	3VA41-HEAB	65,000	N/A	—	(1)#14-3/0 CU/AL	-
25/26/27	110	100	3	3VA41-HEAB	65,000	N/A	—	(1)#14-3/0 CU/AL	-
28/29/30	162	20	3	SPACE	65,000	N/A	—	(1)#14-#8 CU/AL	-
31/32/33	164	20	3	SPACE	65,000	N/A	—	(1)#14-#8 CU/AL	-
34/35/36	166	20	3	SPACE	65,000	N/A	—	(1)#14-#8 CU/AL	-
37/38/39	168	20	3	SPACE	65,000	N/A	—	(1)#14-#8 CU/AL	-
2	114	20	1	3VA41-HEAB	65,000	N/A	—	(1)#14-#8 CU/AL	-
4	116	20	1	3VA41-HEAB	65,000	N/A	—	(1)#14-#8 CU/AL	-
6	118	20	1	3VA41-HEAB	65,000	N/A	—	(1)#14-#8 CU/AL	-
8	121	20	1	3VA41-HEAB	65,000	N/A	—	(1)#14-#8 CU/AL	-
10	123	20	1	3VA41-HEAB	65,000	N/A	—	(1)#14-#8 CU/AL	-
12	125	20	1	3VA41-HEAB	65,000	N/A	—	(1)#14-#8 CU/AL	-
14/16/18	108	100	3	3VA41-HEAB	65,000	N/A	—	(1)#14-3/0 CU/AL	-
20/22/24	111	100	3	3VA41-HEAB	65,000	N/A	—	(1)#14-3/0 CU/AL	-

JOB			
JC Bowman Source Blue			
P.O.		CUST.	
-		CRAWFORD ELECTRIC SUPPLYCOMPANY LLC	
CONTR		CONSLT	
-		-	
TIE		BY	ENG. LOC.
-		everhx01c	-
S.O.		DATE	DESIGNATION
-		7-22-2026	1DHA.DP.H01-2
-		DWG. NO.	
-		everhx01c_07222601_00_00_M00-21000-3	
Siemens Industry, Inc.		APP.	
Norcross, Georgia		MFG. LOC.	REV.
		DWG. FILE	1
		SHEET 3 OF 6	

JOB				
JC Bowman Source Blue				
P.O.		CUST.		
-		CRAWFORD ELECTRIC SUPPLYCOMPANY LLC		
CONTR		CONSULT		
-		-		
TIE		BY	ENG. LOC.	DESIGNATION
-		everhx01c	-	1DHA.DP.H01-2
S.O.		DATE		
-		7-22-2026		
DWG. NO.		everhx01c_07222601_00_00_M00-21000-4		
Siemens Industry, Inc.		APP.	MFG. LOC.	REV.
Norcross, Georgia		APP.	DWG. FILE	SHEET 4 OF 6
				1

APPLICATION ENGINEERING REPORT

UNIQUE ID NUMBER	DESCRIPTION	APPLICATION DESCRIPTION

JOB			
JC Bowman Source Blue			
P.O.		CUST.	
-		CRAWFORD ELECTRIC SUPPLYCOMPANY LLC	
CONTR		CONSULT	
-		-	
TIE		BY	ENG. LOC.
-		everhx01c	-
S.O.		DATE	DESIGNATION
-		7-22-2026	1DHA.DP.H01-2
DWG. NO.		everhx01c_07222601_00_00_M00-21000-5	
Siemens Industry, Inc.		APP.	MFG. LOC.
Norcross, Georgia		APP.	DWG. FILE
		SHEET	5 OF 6
		REV.	1

DETAILED CIRCUIT SCHEDULE

Circuit #	Device Type	Device Catalog #	Frame Amp	Trip Amp	Interrupting Class	Trip Unit Type	Load Rating	# Of Poles	Brkr Trip Setting	COMM	DAS/IZSI	Accessories	Load Lug Size Per Phase
1	-	-	-	-	-	-	-	-	-	-	-	-	-
2	-	-	-	-	-	-	-	-	-	-	-	-	(2)3/0-500KCMIL
3	3VA54-HLAS	3VA54506EC310AA0	600	500	65KAIC	TM	STD	3	-	-	N/N	-	(2)2/0-500KCMIL CU/AL
4	3VA41-HEAB	3VA41206ED140AA0	125	20	65KAIC	TM	STD	1	-	-	N/N	-	(1)#14-#8 CU/AL
5	3VA41-HEAB	3VA41206ED140AA0	125	20	65KAIC	TM	STD	1	-	-	N/N	-	(1)#14-#8 CU/AL
6	3VA41-HEAB	3VA41206ED140AA0	125	20	65KAIC	TM	STD	1	-	-	N/N	-	(1)#14-#8 CU/AL
7	3VA41-HEAB	3VA41206ED140AA0	125	20	65KAIC	TM	STD	1	-	-	N/N	-	(1)#14-#8 CU/AL
8	3VA41-HEAB	3VA41206ED140AA0	125	20	65KAIC	TM	STD	1	-	-	N/N	-	(1)#14-#8 CU/AL
9	3VA41-HEAB	3VA41206ED140AA0	125	20	65KAIC	TM	STD	1	-	-	N/N	-	(1)#14-#8 CU/AL
10	3VA41-HEAB	3VA41206ED140AA0	125	20	65KAIC	TM	STD	1	-	-	N/N	-	(1)#14-#8 CU/AL
11	3VA41-HEAB	3VA41206ED140AA0	125	20	65KAIC	TM	STD	1	-	-	N/N	-	(1)#14-#8 CU/AL
12	3VA41-HEAB	3VA41206ED140AA0	125	20	65KAIC	TM	STD	1	-	-	N/N	-	(1)#14-#8 CU/AL
13	3VA41-HEAB	3VA41206ED140AA0	125	20	65KAIC	TM	STD	1	-	-	N/N	-	(1)#14-#8 CU/AL
14	3VA41-HEAB	3VA41206ED140AA0	125	20	65KAIC	TM	STD	1	-	-	N/N	-	(1)#14-#8 CU/AL
15	3VA41-HEAB	3VA41206ED140AA0	125	20	65KAIC	TM	STD	1	-	-	N/N	-	(1)#14-#8 CU/AL
16	3VA41-HEAB	3VA41106ED340AA0	125	100	65KAIC	TM	STD	3	-	-	N/N	-	(1)#14-3/0 CU/AL
17	3VA41-HEAB	3VA41106ED340AA0	125	100	65KAIC	TM	STD	3	-	-	N/N	-	(1)#14-3/0 CU/AL
18	3VA41-HEAB	3VA41106ED340AA0	125	100	65KAIC	TM	STD	3	-	-	N/N	-	(1)#14-3/0 CU/AL
19	3VA41-HEAB	3VA41106ED340AA0	125	100	65KAIC	TM	STD	3	-	-	N/N	-	(1)#14-3/0 CU/AL
20	-	-	-	-	-	-	-	-	-	-	-	-	-
21	-	-	125	20	65KAIC	TM	STD	3	-	-	N/N	-	(1)#14-#8 CU/AL
22	-	-	-	-	-	-	-	-	-	-	-	-	-
23	-	-	125	20	65KAIC	TM	STD	3	-	-	N/N	-	(1)#14-#8 CU/AL
24	-	-	-	-	-	-	-	-	-	-	-	-	-
25	-	-	125	20	65KAIC	TM	STD	3	-	-	N/N	-	(1)#14-#8 CU/AL
26	-	-	-	-	-	-	-	-	-	-	-	-	-
27	-	-	125	20	65KAIC	TM	STD	3	-	-	N/N	-	(1)#14-#8 CU/AL

JOB			
JC Bowman Source Blue			
P.O.		CUST.	
-		CRAWFORD ELECTRIC SUPPLYCOMPANY LLC	
CONTR		CONSLT	
-		-	
TIE		BY	ENG. LOC.
-		everhx01c	-
S.O.		DATE	DESIGNATION
-		7-22-2026	1DHA.DP.H01-2
DWG. NO.		everhx01c_07222601_00_00_M00-21000-6	
Siemens Industry, Inc.		APP.	MFG. LOC.
Norcross, Georgia		APP.	DWG. FILE
		SHEET 6 OF 6	
		REV. 1	